

Level 02, GA, as built  
1 : 50

Make good area of wall where existing partition has been demolished

Install capped "T" junction in new drainage run for future WC Connection


Make good area of wall where existing partition has been demolished

Internal Lobby door to have hold open device

following statements. All drawings are based upon site information supplied by third parties/sub contractors and as such their accuracy cannot be guaranteed. All features are approximate and subject to clarification by a detailed topographical survey, statutory service enquiries and confirmation of the legal boundaries. Check all dimensions on site. Drawings printed on mediums such as paper are not to be relied upon for scaling purposes as dimensional inaccuracy occur resulting from changes in environmental conditions. Use figured dimensions in : cases. All dimensions to be in metric standards unless stated otherwise

Property of Sanderson Weatherall, 25 Wellington Street, Leeds, LS1 4WG. All rights of the copyright holders reserved. Unauthorised copying, hiring, lending of this data for financial or commercial gain prohibited

01_First Issue	MJo	04/01/22
02_General Revisions	MJo	16/03/22
03_As built Information	JM	13/07/22

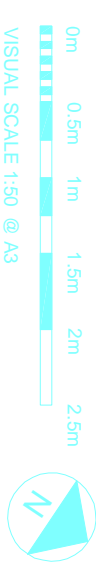

ALAN SA

Client :  
**AL,AN SA**  
Address :  
94 Kensington High Street, London W8 4SG

Drawing :  
**Level 02, GA, as built**

Job Ref : 212294  
Dwg No : 300-01  
Revision : 03

Drawn : MJo  
Checked : SRI  
Scale : @A3  
1 : 50

- Key**
- Demolition of existing:**
- Partitions
- Finishes:**
- Wall 01**  
Make good walls throughout and prepare to receive Dulux Trade Diamond Matt in Grey Whisp
  - Wall 02**  
Make good walls throughout and prepare to receive 75x150mm Metro Brick Gloss White Wall Tiles
- Floor 01**  
Forbo Allura Click Pro LVT in 60293CL5 Steamed Oak
- Floor 02**  
Serpe Crean 450x450mm Floor Tiles
- Double plug socket